


ELEVATION PLAN

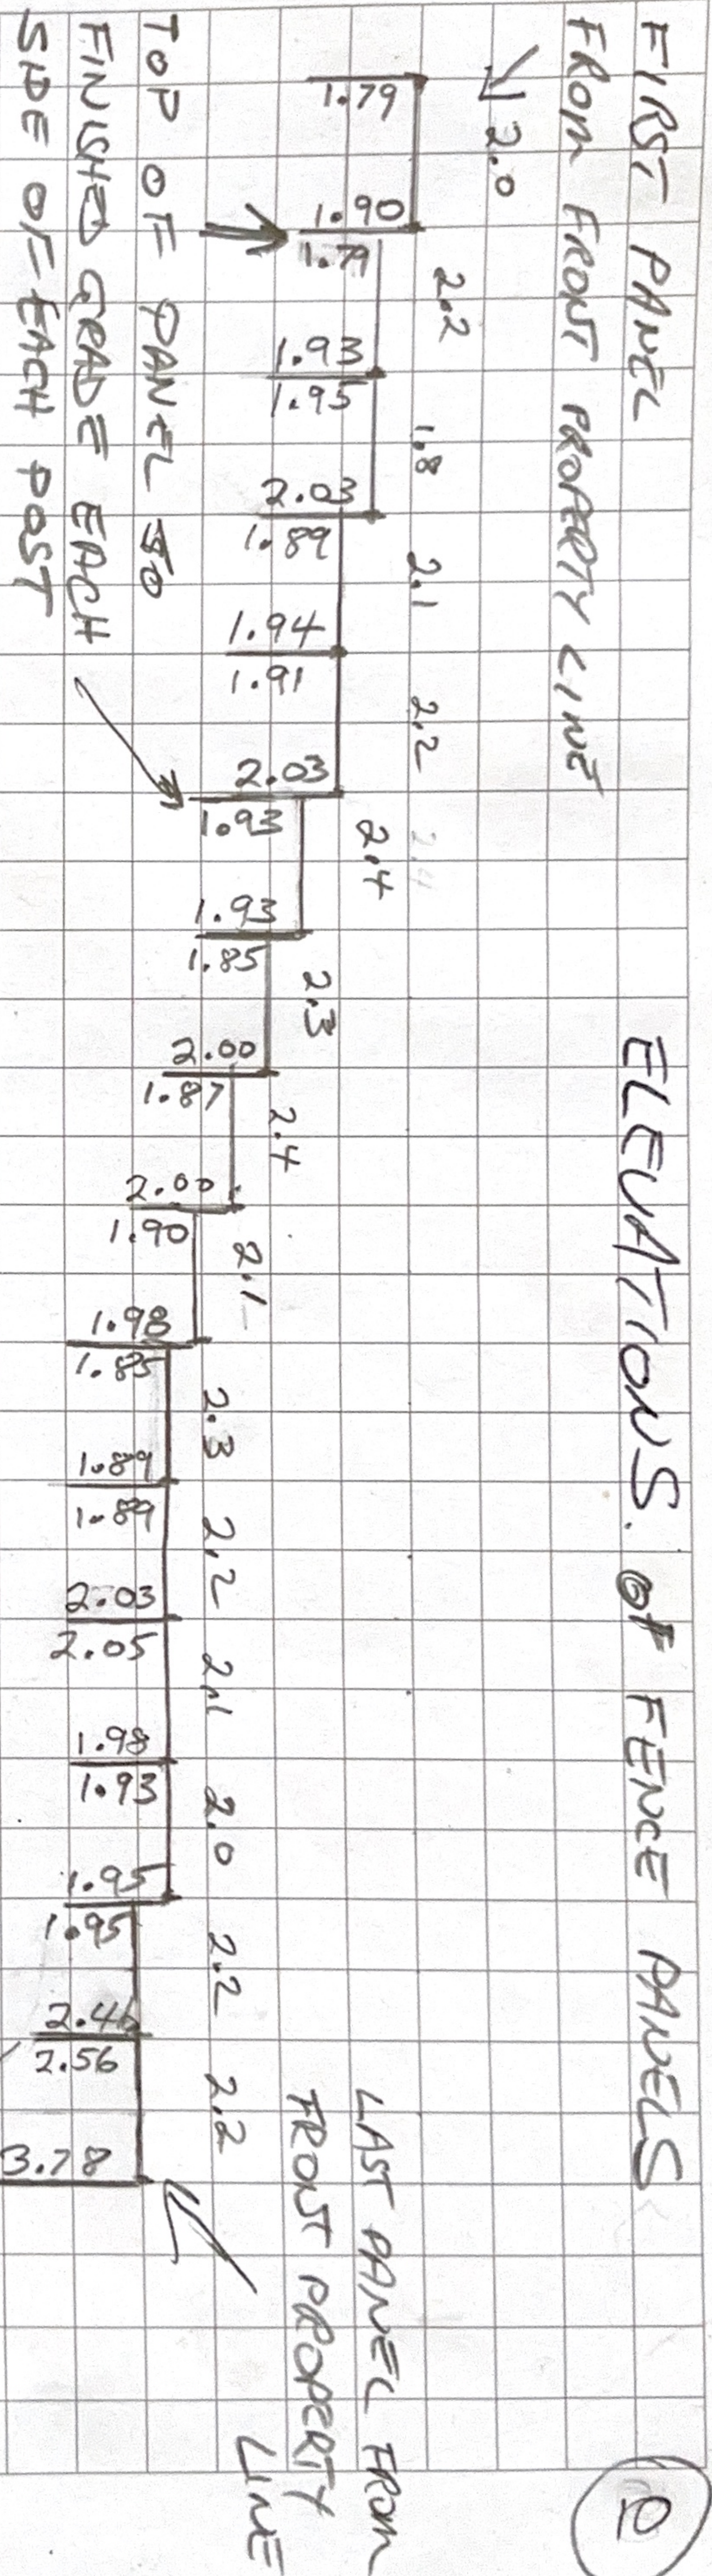

EACH STEP DOWN ALONG FENCE IS 6" TO MATCH SLOPE OF LAND

ALL METAL FENCE PANELS ARE 1.8288 M OR 6' HIGH EXCEPT THE FIRST TWO NEW PANELS ARE 1.67 M OR 5'6" HIGH

VERTICAL MEASUREMENT ARE FROM TOP OF PANEL TO GROUND

HORIZONTAL MEASUREMENTS ARE WIDTH OF PANEL BETWEEN POSTS

POSTS ARE 6"x6" PRESSURE TREATED, BURIED 3' IN GROUND ENCASED IN CEMENT

FENCE IS LOCATED INSIDE PROPERTY LINE OF 4012 SUMMERS CR.

FENCE WAS BUILT BY SOUTH OKANAGAN FENCE INSTALLATIONS

THE FIRST 13 PANELS HAVE AN AVERAGE HEIGHT OF 76.22" OR 1.9359 M

THE TOP OF THE LAST TWO PANELS ARE 1.8 M ABOVE NEIGHBOURS GRASS

BECAUSE OF THE 6/12 DROP OFF, THE TOP OF THE LAST PANEL IS 2.56 TO 3.78 M ABOVE GRADE